



INDIANA DEPARTMENT OF TRANSPORTATION

STANDARDS COMMITTEE MEETING AGENDA

Driving Indiana's Economic Growth

September 5, 2006

MEMORANDUM

TO: Standards Committee

FROM: Dannie L. Smith, Secretary

RE: Agenda for the September 21, 2006 Standards Committee Meeting

A Standards Committee meeting is scheduled for 9:00 a.m. on September 21, 2006 in the N755 Bay Window Conference Room. The following agenda items are listed for consideration.

Old Business

Item 13-3 729	Ms. Rearick <i>Patching Non-Deck Areas of Bridge Structures</i>	9/21/06 700-158	3
------------------	--	--------------------	---

New Business

Item 15-1 101.03	Mr. Kuchler Blank <i>Auxiliary Lane</i>	9/21/06 100-3	7
Item 15-2 205.06	Mr. Heustis Method of Measurement	9/21/06 200-51	8
Item 15-3 507.04(a)	Mr. Heustis Sawing, Cleaning and Sealing	9/21/06 500-45	9
Item 15-4 604.02	Mr. Walker Materials	9/21/06 600-14	11
Item 15-5 Standard Drawings	Mr. Andrews 610-DRIV-01 thru 04 610-DRIV-06, 08, 12, 13, 15, Thru 19	9/21/06	12
Item 15-6 715.02	Mr. Heustis Materials	9/21/06 700-105	28
Item 15-7	Mr. Heustis	9/21/06	29

715.02(k)	<i>Pipe End Sections</i>	700-108	
Item 15-8 715.06	Mr. Heustis Joining Pipe	9/21/06 700-110	30
Item 15-9 724.02(b) 724.03	Ms. Rearick Expansion Joint M General Requirements	9/21/06 700-150 700-150	31
Item 15-10 801.15(c)	Mr. Rust Temporary Worksite Speed Limit Sign Assembly	9/21/06 800-15	33
Item 15-11 905.05	Mr. Walker Detectable Warning Elements	9/21/06 900-37	34
Item 15-12 908.02	Mr. Heustis Corrugated Steel Pipe and Pipe Arches	9/21/06 900-49	35
Item 15-13 918.02	Mr. Walker Geotextile for Use Under Riprap	9/21/06 900-142	36
Item 15-14 Design Manual	Mr. Wright Section 14-1.02(02) and Section 17-3.02(01)	9/21/06	38

cc: Committee Members (11)
FHWA (4)
ICI Representative (1)

REVISION TO 2006 STANDARD SPECIFICATIONS

SECTION 729, BEGIN LINE 1, INSERT AS FOLLOWS:

SECTION 726 – BLANK

SECTION 727 – BLANK

SECTION 728 – BLANK

SECTION 729 – PATCHING NON-DECK AREAS OF BRIDGE STRUCTURES

729.01 Description

This work shall consist of the removal of existing concrete from outside the deck area of a bridge structure and replacing such concrete with new mortar or concrete in accordance with 105.03.

729.02 Materials

Materials shall be in accordance with the following:

Concrete, Class A.....	702.02
Epoxy Resin Adhesive	909.11

The cement shall be portland cement type I.

Mortar shall consist of one part portland cement to two parts No. 23 sand.

An epoxy resin adhesive shall be selected from the Department's list of approved Non-Vapor Barrier Type Bonding Agents.

CONSTRUCTION REQUIREMENTS

729.03 Construction Requirements

(a) Concrete Removal

Areas of unsound concrete to be removed will be marked by the Engineer. Removal of the unsound concrete shall be performed by handchipping. Handchipping tools may be hand or mechanically driven. Jack hammers shall not be heavier than nominal 45 lb (20.5 kg) class and chipping hammers shall not be heavier than nominal 15 lb (6.8 kg) class. Only chipping hammers shall be used when removing concrete within 1 in. (25 mm) of reinforcing steel. Mechanically driven tools shall be operated at a maximum angle of 45 degrees from the concrete surface. Power-driven hand tools for removal by hand chipping will be permitted, as set out above.

Regardless of the method of removal, the removal operation shall be stopped if it is determined that sound concrete is being removed. Appropriate recalibration, or changes in equipment and methods shall be performed prior to resuming the removal operation.

Where the bond between the existing concrete and reinforcing steel has been destroyed, the concrete adjacent to the steel shall be removed to a minimum clearance of

1 in. (25 mm) around the entire periphery of the exposed steel. Exposed reinforcing steel shall not be damaged by the removal operation. All damaged reinforcing steel shall be replaced or repaired as directed.

A saw cut shall be made perpendicular to the existing concrete surface at least 1 in. (25 mm) outside the spalled area before the mortar or concrete is placed. The cut shall be a minimum 1 in. (25 mm) deep or to the top of reinforcing steel, whichever is less.

(b) Patching

After the concrete removal operation is completed and just prior to placing the patches, all patch areas shall be sandblasted to expose fine and coarse aggregates and to remove unsound concrete or laitance layers from the surface. Exposed reinforcing steel and the concrete under and around the exposed steel shall be cleaned by sandblasting. The surface shall then be cleaned free of all dust, chips, water, and foreign material to the extent necessary to produce a firm, solid surface for adherence of the new concrete. The final surface shall be free of oil, grease and water. The air lines for sandblasting and air cleaning shall be equipped with oil traps.

The surfaces of the prepared cavities and all the exposed reinforcing steel within the cavities shall be coated with an epoxy resin adhesive in accordance with 722.06(a)1 prior to placement of the patching materials.

Cavities of 1/2 in. (13 mm) in depth or greater shall be filled with concrete. Cavities less than 1/2 in. (13 mm) in depth, shall be filled with mortar.

The concrete patches shall be finished to closely match the texture and finish of the abutting existing concrete.

The concrete patches shall be cured in accordance with 702.22.

729.04 Method of Measurement

Patching of non-deck areas of bridges will be measured by the square foot (square meter). Measurements will be recorded for payment as follows:

- (a) Patches greater than 0 and less than or equal to 0.5 ft² (0.05 m²) will be recorded as 0.5 ft² (0.05 m²).*
- (b) Patches greater than 0.5 ft² (0.05 m²) and less than or equal to 1 ft² (0.1 m²) will be recorded as 1.0 ft² (0.1 m²).*
- (c) Patches greater than 1.0 ft² (0.1 m²) will be recorded as the actual measurement of the patch to the nearest 0.1 ft² (0.01 m²).*

729.05 Basis of Payment

This work will be paid for at the contract unit price per square foot (square meter) for concrete, A, patching.

Payment will be made under:

REVISION TO 2006 STANDARD SPECIFICATIONS

SECTION 729, CONTINUED.

Pay Item

Pay Unit Symbol

Concrete, A, Patching SFT (m^2)

The areas where the patching exceeds an average of 4 in. (100 mm) in depth will be paid for at a price to be determined by multiplying the contract unit price for concrete, A, patching by the following factors:

- (a) *For portions thereof whose average depth is greater than 4 in. (100 mm) but not more than 6 in. (150 mm)1.25*
- (b) *For portions thereof whose average depth is greater than 6 in. (150 mm) but not more than 8 in. (200 mm)1.50*
- (c) *For portions thereof whose average depth is greater than 8 in. (200 mm) but not more than 10 in. (250 mm)1.75*
- (d) *For portions thereof whose average depth is greater than 10 in. (250 mm) but not more than 12 in. (300 mm)2.00*
- (e) *For all portions thereof whose average depth is greater than 12 in. (300 mm), the work shall be done as extra work. Payment will be made in accordance with 104.03.*

The cost of removing the existing concrete, furnishing, hauling, and placing all materials, preparing the surface, and all necessary incidentals shall be included in the cost of concrete, A, patching.

The cost of replacing or repairing damaged reinforcing steel shall be included in the cost of concrete, A, patching.

Other sections containing
specific cross references:

None

General Instructions to Field Employees

Update Required? Y___ N___

By - Addition or Revision

Frequency Manual

Update Required? Y___ N___

By - Addition or Revision

Recurring Special Provisions
potentially affected:

729-B-009

Standard Sheets potentially affected:

None

Motion: M

Second: M

Ayes:

Nays:

Action: Passed as submitted; revised

Effective: _____ Letting

_____ 2008 Standards Specifications Book

_____ 2008 Standards Edition

Withdrawn _____

Received FHWA Approval? _____

Smith, Dan

From: Heustis, Ronald
Sent: Wednesday, August 02, 2006 9:37 AM
To: Smith, Dan
Cc: Chumbley, Sharman; Rearick, Anne
Subject: Section 729
Attachments: SECTION 729 Draft.doc

Dan,

Attached is a draft of section 729 – Patching Non-Deck Areas of Bridge Structures. This item was withdrawn from the June Stds. Comm. meeting for rewrite. The attached highlights the changes made and has been approved by Anne Rearick for resubmittal to the committee. Please place it on the agenda for September.

thanks,

Ron

Ronald Heustis, P.E.
INDOT
Manager, Construction Technical Support
Division of Construction Management
317-234-2777
317-232-0676 fax
317-691-6620 cell
rheustis@indot.in.gov
www.state.in.us/dot

8/2/2006

REVISION TO 2006 STANDARD SPECIFICATIONS

SECTION 101, LINE 114,DELETE AND INSERT AS FOLLOWS:

101.03 ~~Blank~~ Auxiliary Lane

An auxiliary lane is defined as the portion of the roadway adjoining the traveled way for parking, speed change, right & left turning movements, storage for turning, weaving, truck climbing, passing blisters and other purposes supplementary to through-traffic movement.

Other sections containing
specific cross references:

None

General Instructions to Field Employees

Update Required? Y___ N___

By - Addition or Revision

Frequency Manual

Update Required? Y___ N___

By - Addition or Revision

Recurring Special Provisions
potentially affected:

None

Standard Sheets potentially affected:

None

Motion: Mr.
Second: Mr.
Ayes:
Nays:

Action: Passed as submitted; revised
Effective - _____ Letting
_____ Supplementals

Withdrawn

Received FHWA Approval? _____

REVISION TO 2006 STANDARD SPECIFICATIONS

SECTION 205, BEGIN LINE 134, INSERT AS FOLLOWS:

205.06 Method of Measurement

Silt fence and straw bale check dams will be measured by the linear foot (meter).
| *Straw bale check dams will be measured once per dam parallel to the dam and at the widest points.* Sediment basins will be measured by the units installed complete in place. Revetment riprap check dams, sediment traps, and splashpads will be measured by the ton (megagram). *The measurement of temporary revetment riprap check dams will include the revetment riprap and the No. 5 stone.* Measurement of sediment traps will include the riprap and the No. 8 filter stone. Temporary mulching will be measured by the ton (megagram).

Other sections containing
specific cross references:

None

Recurring Special Provisions
potentially affected:

205-R-528

Motion: M
Second: M
Ayes:
Nays:

General Instructions to Field Employees

Update Required? Y___ N___

By - Addition or Revision

Frequency Manual

Update Required? Y___ N___

By - Addition or Revision

Standard Sheets potentially affected:

205-TECD-02

Action: Passed as submitted; revised
Effective: _____ Letting
_____ 2008 Standards Specifications Book
_____ 2008 Standards Edition

Withdrawn _____

Received FHWA Approval? _____

REVISION TO 2006 STANDARD SPECIFICATIONS

SECTION 507, BEGIN LINE 68, DELETE AND INSERT AS FOLLOWS:

(a) Sawing, Cleaning and Sealing

Joints in PCCP shall be sawed, cleaned and sealed when specified. Air compressors shall be capable of producing a minimum air pressure of 100 psi (690 kPa). Water blasting shall not be ~~utilized~~ *applied under pressure which may damage the concrete*. The existing joints shall be sawed to the width and depth as shown on the plans. Slurry or saw residue remaining in the slot shall be immediately flushed *with water*. Traffic may be allowed on the PCCP for up to 7 calendar days after the saw cutting prior to sealing.

Joints shall be sealed with joint sealing materials in accordance with the sealant manufacturer's recommendations. Transverse joints shall be sealed with silicone sealant or preformed ~~electrometric~~ *elastomeric* joint sealant. Longitudinal joints shall be sealed with an asphalt rubber or silicone sealants.

Application of asphalt materials shall be completed without covering existing pavement markings. When traffic is to be maintained within the limits of the section, temporary traffic control measures in accordance with 801 shall be used. Treated areas shall not be opened to traffic until the asphalt material has set.

Other sections containing
specific cross references:

507.06, Pg. 500-46

Recurring Special Provisions
potentially affected:

None

Motion: M
Second: M
Ayes:
Nays:

General Instructions to Field Employees

Update Required? Y___ N___

By - Addition or Revision

Frequency Manual

Update Required? Y___ N___

By - Addition or Revision

Standard Sheets potentially affected:

None

Action: Passed as submitted; revised
Effective: _____ Letting
_____ 2008 Standards Specifications Book
_____ 2008 Standards Edition

Withdrawn _____

Received FHWA Approval? _____

From: Novak, Joseph
Sent: Thursday, August 03, 2006 10:36 AM
To: Heustis, Ronald
Cc: Kuchler, Dennis; Andrews, David
Subject: Spec revision for PCCP joint seal prep

Ron,

Attached is a proposed revision to the 507.04 spec for joint seal preparation. This wording change proposed for the water blasting is identical to that which already exists in 503.05. Also the spec was further clarified to direct that flushing must occur with water (not air) although that should be clear enough already. The intent of the change is to help ensure we are getting proper joint prep for our seals. If you concur with these changes please place on the Standards Committee agenda. Joe

Joseph J. Novak, P.E.
Construction Field Engineer
INDOT - Central Office
Division of Contracts & Construction
Rm N855, 100 N. Senate Ave
Indianapolis, IN 46204
Phone: 317-232-5081

8/4/2006

Item No. 4
Mr. Walker
Date: 9/21/06

REVISION TO 2006 STANDARD SPECIFICATIONS

SECTION 604, BEGIN LINE 29, DELETE AS FOLLOWS:

~~A type A certification in accordance with 916 for detectable warning elements and thin set latex modified mortar shall be furnished prior to use of the materials.~~

Other sections containing
specific cross references:

None

Recurring Special Provisions
potentially affected:

None

Motion: M
Second: M
Ayes:
Nays:

General Instructions to Field Employees

Update Required? Y___ N___

By - Addition or Revision

Frequency Manual

Update Required? Y___ N___

By - Addition or Revision

Standard Sheets potentially affected:

None

Action: Passed as submitted; revised
Effective: _____ Letting
_____ 2008 Standards Specifications Book
_____ 2008 Standards Edition

Withdrawn _____

Received FHWA Approval? _____

Smith, Dan

From: Miller, Mark (INDOT)
Sent: Tuesday, July 18, 2006 10:55 AM
To: Smith, Dan
Subject: Detectable Warning Elements
Attachments: 604.doc

Dan – this is a needed revision because we have established an approved list for DWEs. Currently we only have one source on the list. Other standard changes will be submitted as the committee decides what to do. I am not sure that 604.02 is the right place for the basis of use. Would 905.05 be the place?

Mark A. Miller, Director
Construction Management Division
Indiana Department of Transportation
IGCN 100 N. Senate Ave Rm N855
Indianapolis, IN 46204
317-232-5456
Fax 317-232-0676
mmiller@indot.in.gov

7/18/2006

REVISION TO STANDARD DRAWINGS

610-DRIV-01, Class I Drive
610-DRIV-02, Class II Drive
610-DRIV-03, Class III Drive
610-DRIV-04, Class IV Drive
610-DRIV-06, Class VI Drive Plan and Sections
610-DRIV-08, Class I and Class III Drive Grade Profiles
610-DRIV-12, Class VII Drive Profile Grade & Detail A
610-DRIV-13, Drives General Notes and Legend
610-DRIV-15, Class VII Drive Plan and Profile Grade
610-DRIV-16, Class VII Drive Joint Placement and Corners
610-DRIV-17, Private Drive Crossovers Plans
610-DRIV-18, Private Drive Crossovers Cross Sections
610-DRIV-19, Commercial Drive Crossovers Plans

The above listed standard drawings are being revised to reflect thicker pavement sections.

Other sections containing
specific cross references:

None

General Instructions to Field Employees

Update Required? Y___ N___

By - Addition or Revision

Frequency Manual

Update Required? Y___ N___

By - Addition or Revision

Recurring Special Provisions
potentially affected:

None

Standard Sheets potentially affected:

See Above

Motion: M
Second: M
Ayes:
Nays:


Action: Passed as submitted; revised
Effective: _____ Letting
_____ 2008 Standards Specifications Book
_____ 2008 Standards Edition

Withdrawn _____

Received FHWA Approval? _____


NOTES:

1. See Standard Drawing E 610-DRIV-13 for General Notes.
2. See Standard Drawings E 604-SDWK-01 or E 604-SDWK-02 for sidewalk elevation transition details.
3. See Standard Drawings E 610-DRIV-03 for concrete curb and gutter connection detail.
4. See Standard Drawings E 610-DRIV-07 for PCPP joint placement detail.
5. Class I drive pavement shall be 6 in. PCPP of compacted aggregate base *on dense graded subbase on subgrade treatment* for section AA and B-B.
6. See Standard Drawings E 610-DRIV-08 for section AA and B-B.

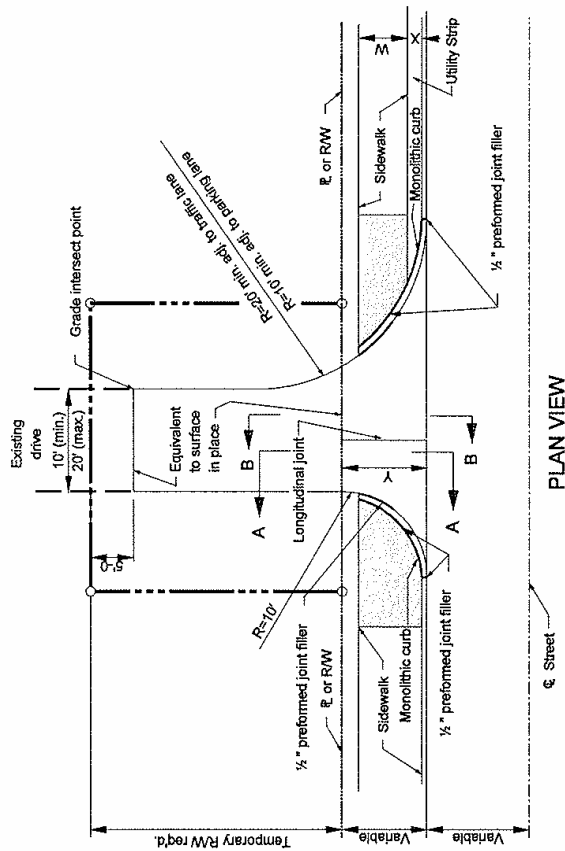

PLAN VIEW

LEGEND


- W = Width of sidewalk
X = Distance between back face of curb and sidewalk
Y = Distance from front face of curb to \mathbb{R} or RW
 Sidewalk elevation transition.


INDIANA DEPARTMENT OF TRANSPORTATION

CLASS I DRIVE

MARCH 2006

STANDARD DRAWING NO. E 610-DRIV-01

	<i>/s/ Richard L. VanDine</i> REGIONAL ENGINEER	3-0-06 DATE
	<i>/s/ Richard L. VanDine</i> CHIEF HIGHWAY ENGINEER	3-0-06 DATE

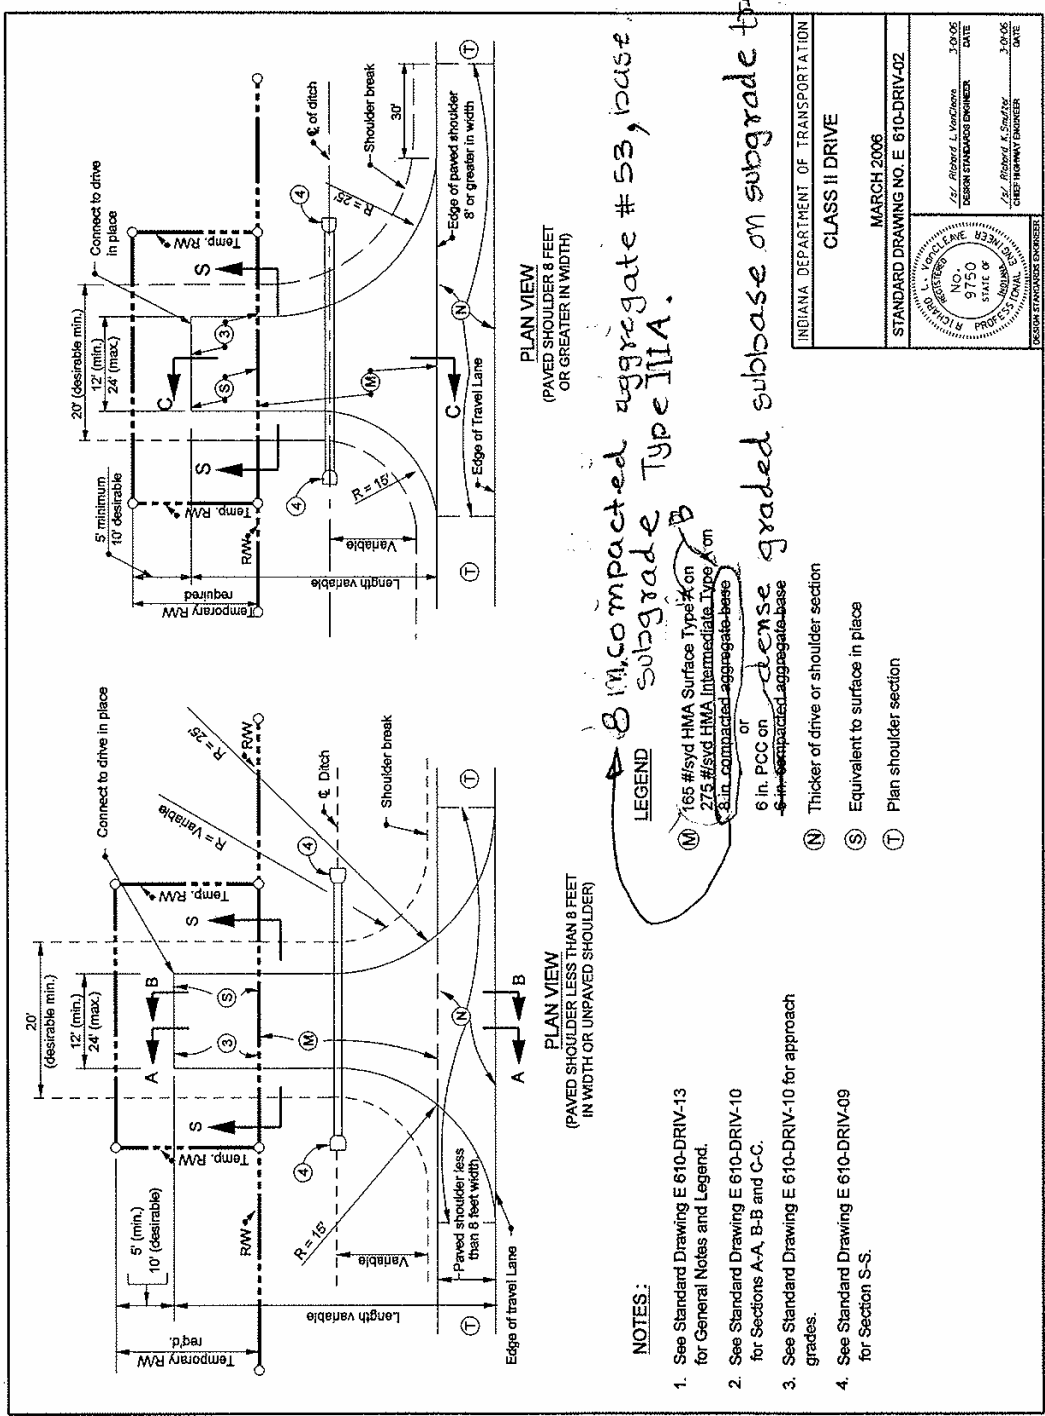

8 in. compacted aggregate #53, base on subgrade Type IIIA.

or

6 in. PCC on 8 in. compacted aggregate base


or

6 in. dense graded subbase on subgrade treatment Type IIIA.

INDIANA DEPARTMENT OF TRANSPORTATION	
CLASS II DRIVE	
MARCH 2008	
STANDARD DRAWING NO. E 610-DRIV-02	
	DESIGNED BY Richard L. VanCleave DATE 3/06/08
CHECKED BY DATE 3/06/08	DESIGNED BY DATE 3/06/08


NOTES:

1. See Standard Drawing E 610-DRIV-08 for Section A-A, and Section B-B.
2. For Class III drive, ~~per 91M PCCP~~ **on dense graded subbase** pavement for driveways shall be placed ~~on compacted aggregate base~~ **on subgrade treatment Type IIIA.**
3. See Standard Drawings E 604-SDWK-01 or E 604-SDWK-02 for side walk elevation transition details, or Standard Drawing E 604-SWCR-09 for sidewalk curb ramp details if the drive is signalized.

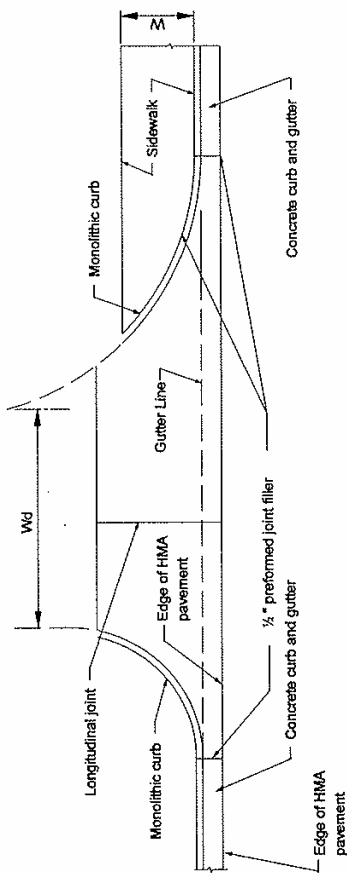

CONCRETE CURB & GUTTER CONNECTION FOR CLASS I & III DRIVES

- LEGEND**
- W = Width of sidewalk
 - Wd = Driveway width
 - X = Distance between back face of curb and sidewalk
 - Y = Distance from front face of curb to R or RW
 - Sidewalk elevation transition.

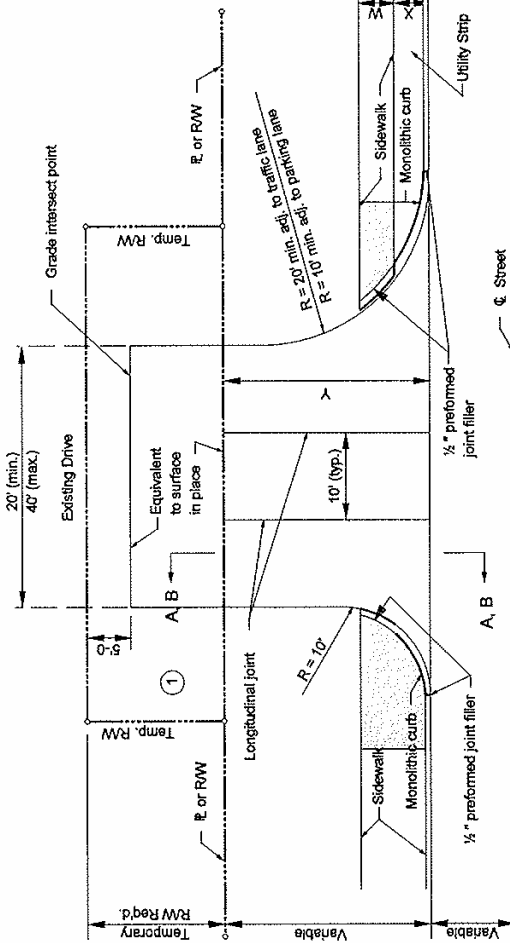


PLAN VIEW - CLASS III DRIVE

INDIANA DEPARTMENT OF TRANSPORTATION	
CLASS III DRIVE	
MARCH 2006	
STANDARD DRAWING NO. E 610-DRIV-03	
	DATE 3-20-06 DESIGN STANDARD ENGINEER /s/ Richard L. VanCleave
	DATE 3-20-06 CHIEF DRAWING ENGINEER /s/ Richard K. Smutzer


NOTES:

1. See Standard Drawing E 610-DRIV-13 for General Notes and Legend.
2. See Standard Drawing E 610-DRIV-10 for Sections A-A, B-B, and C-C.
3. See Standard Drawing E 610-DRIV-09 for Sections P-P.

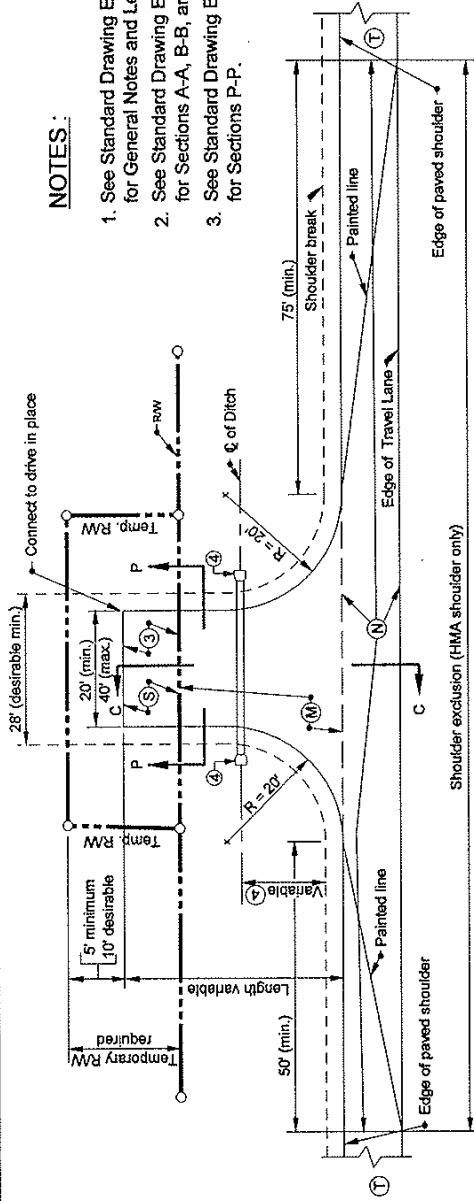

PLAN VIEW

(PAVED SHOULDER 8 FEET OR GREATER IN WIDTH)

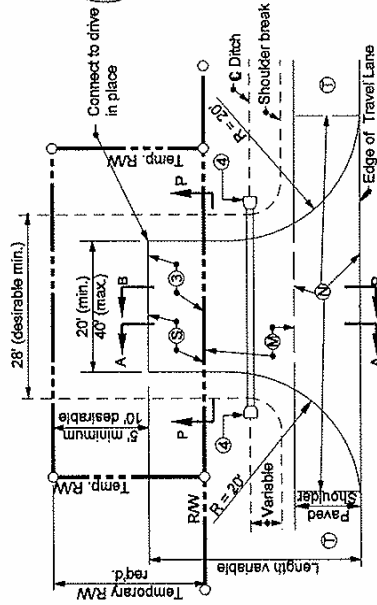

PLAN VIEW

(PAVED SHOULDER LESS THAN 8 FEET IN WIDTH OR UNPAVED SHOULDER)


880 #/syd. HMA base, Type B on
G.M. compacted aggregate #53, base on
subgrade Type IIIA.



LEGEND

- (M) 165 #/syd HMA Surface Type B on 275 #/syd HMA Intermediate Type A on 6-in. compacted aggregate base
- (S) 1/2 in. PCC on 6-in. compacted aggregate base
- (N) Thicker of drive or shoulder section
- (S) Equivalent to surface in place
- (T) Plan shoulder section

INDIANA DEPARTMENT OF TRANSPORTATION	
CLASS IV DRIVE	
MARCH 2006	
STANDARD DRAWING NO. E 610-DRIV-04	
DESIGNED BY A/E Richard L. Vandenberg DATE 3/04/06	CHECKED BY A/E Richard L. Vandenberg DATE 3/04/06
DESIGNED BY A/E Richard L. Vandenberg DATE 3/04/06	CHECKED BY A/E Richard L. Vandenberg DATE 3/04/06

dense graded subbase on
subgrade treatment Type III A.

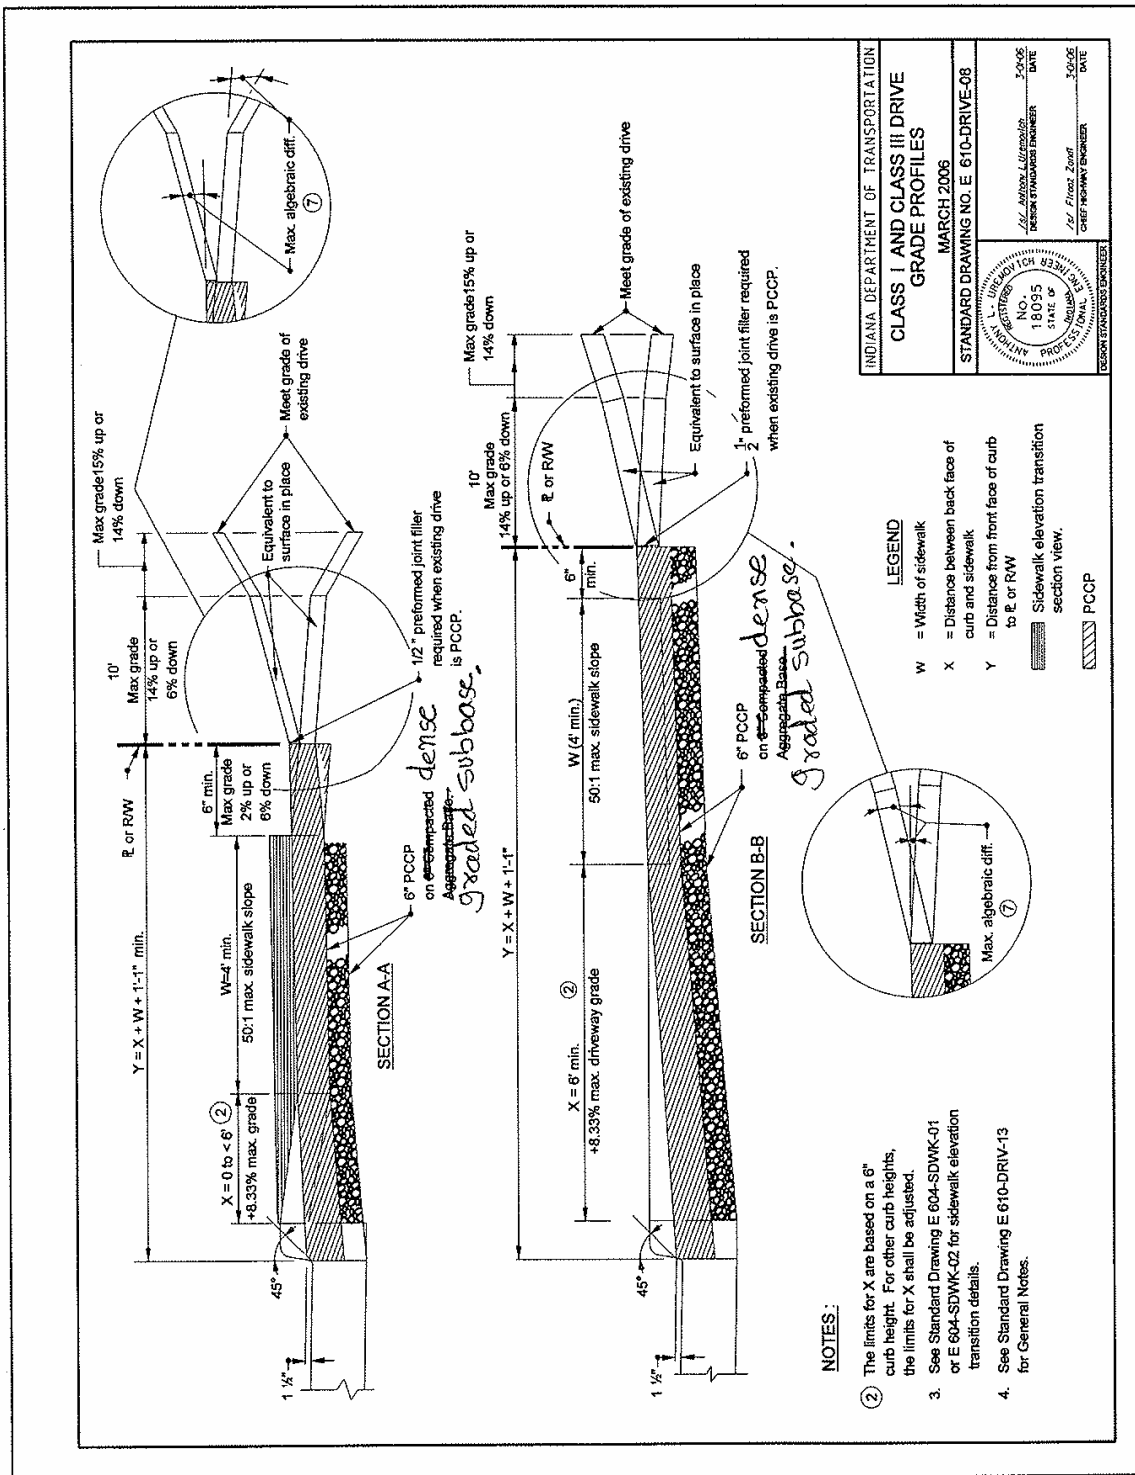

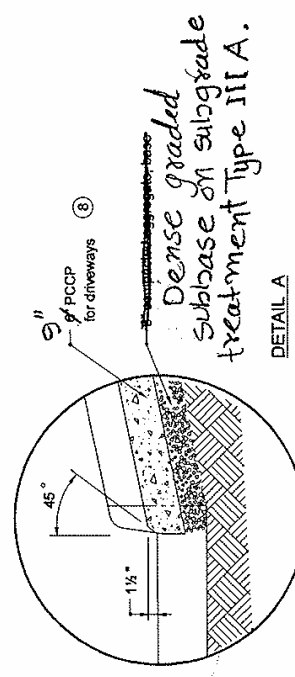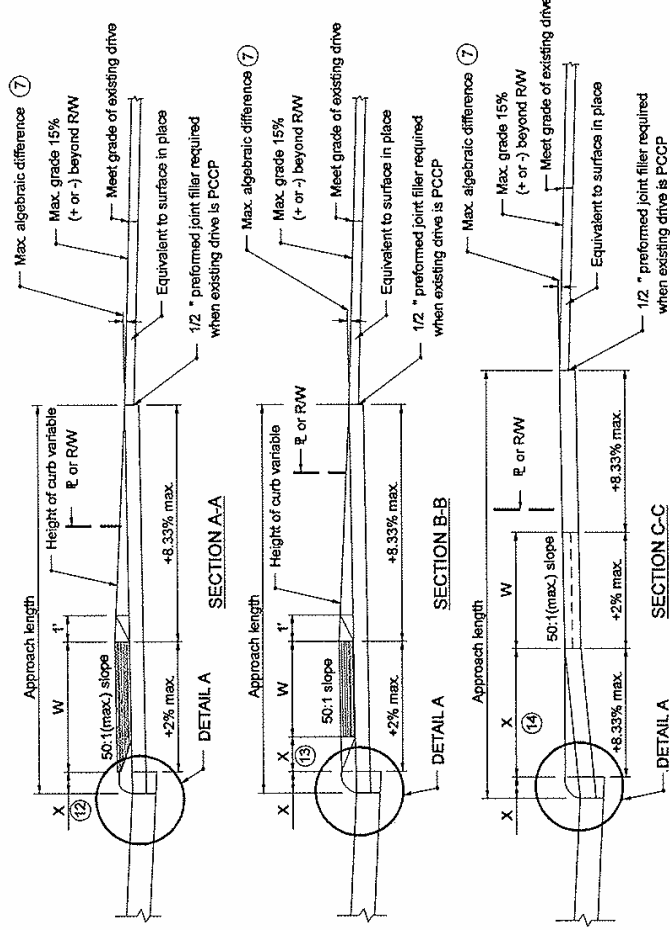

NOTES:

1. See Standard Drawing E 610-DRIV-07 for plan of Class VII drive.
2. See Standard Drawing E 610-DRIV-13 for General Notes and Legend.


INDIANA DEPARTMENT OF TRANSPORTATION	
CLASS VII DRIVE	
PROFILE GRADE & DETAIL A	
MARCH 2006	
STANDARD DRAWING NO. E 610-DRIV-12	
DESIGNED BY Robert L. Fortness DESIGN STANDARDS ENGINEER	CHECKED BY Robert A. Swartz CHIEF HIGHWAY ENGINEER
DATE 3-01-06	DATE 3-01-06


GENERAL NOTES:

- ① These notes apply to Standard Drawings E 610-DRIV-01 through 12.
2. If a PCCP approach is designed for a class II or class IV drive, the radii shall be constructed using ear construction type C as detailed on Standard Drawing E 605-ERCN-02.
- ③ When the maximum approach grade of $\pm 10\%$ does not meet the grade of the existing drive before the RW line, the approach grade of $\pm 10\%$ shall extend beyond the RW to the point of intersection with the existing driveway grade. Construction beyond the RW line shall be done in temporary RW.
- ④ The appropriate pipe end treatment should be provided for pipes located either inside the clear zone or outside the clear zone.
- ⑦ The maximum algebraic difference in grades shall not exceed 8% for crested grade nor 12% for sagged grades for Types I and III drives, nor 11% for crested grade and 14% for sagged grades for Types II, IV, and V drives.
- ⑧ The minimum driveway pavement sections for Class VI and Class VII Drives have been designed for 200 trucks per day. If the truck traffic count is greater than 200 per day, the required pavement section shall be as shown elsewhere on the plans.
- ⑪ Hc - earth cover over culvert or pipe shall be 1 ft or greater.
- ⑫ Curb ramp type H, as shown on Standard Drawing E 604-SWCR-09, when the approach is signalized, or a sidewalk elevation transition as shown on Standard Drawing E 604-SDWK-02 shall be used when sidewalk is adjacent to curb.
- ⑬ When X is equal to or greater than 2 ft but less than 6 ft, either a curb ramp type G as shown on Standard Drawing E 604-SWCR-09, when the approach is signalized, or a sidewalk elevation transition as shown on Standard Drawing E 604-SDWK-01 shall be used.
- ⑭ When X is equal to or greater than 6 ft, no curb ramp or sidewalk elevation transition is required unless the curb height is in excess of 6 inches.
- ⑮ Driveway embankment slope within the clear zone for a road functionally classified as follows shall be:
 - a.) 6:1 for an arterial or a high speed (50 mph or greater design speed) collector.
 - b.) 4:1 for a local road or a low speed (less than 50 mph design speed) collector.

LEGEND

- ⑤ ½ in. preformed joint filler
 - ⑥ Monolithic curb
 - ⑨ Longitudinal joint
 - ⑩ Concrete sidewalk
 - ⑪ For type and thickness equivalent to surface in place, see plans.
- X = Distance between face of curb and sidewalk
 W = Width of sidewalk
 PCCP
- Curb ramp, if signalized, or typically, sidewalk elevation transition.
 Curb ramp or sidewalk elevation transition section view.

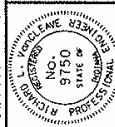INDIANA DEPARTMENT OF TRANSPORTATION	
DRIVES GENERAL NOTES AND LEGEND MARCH 2006 STANDARD DRAWING NO. E 610-DRIV-13	
RICHARD L. VOCHONG DESIGN STANDARDS ENGINEER	RICHARD L. VOCHONG DESIGN STANDARDS ENGINEER

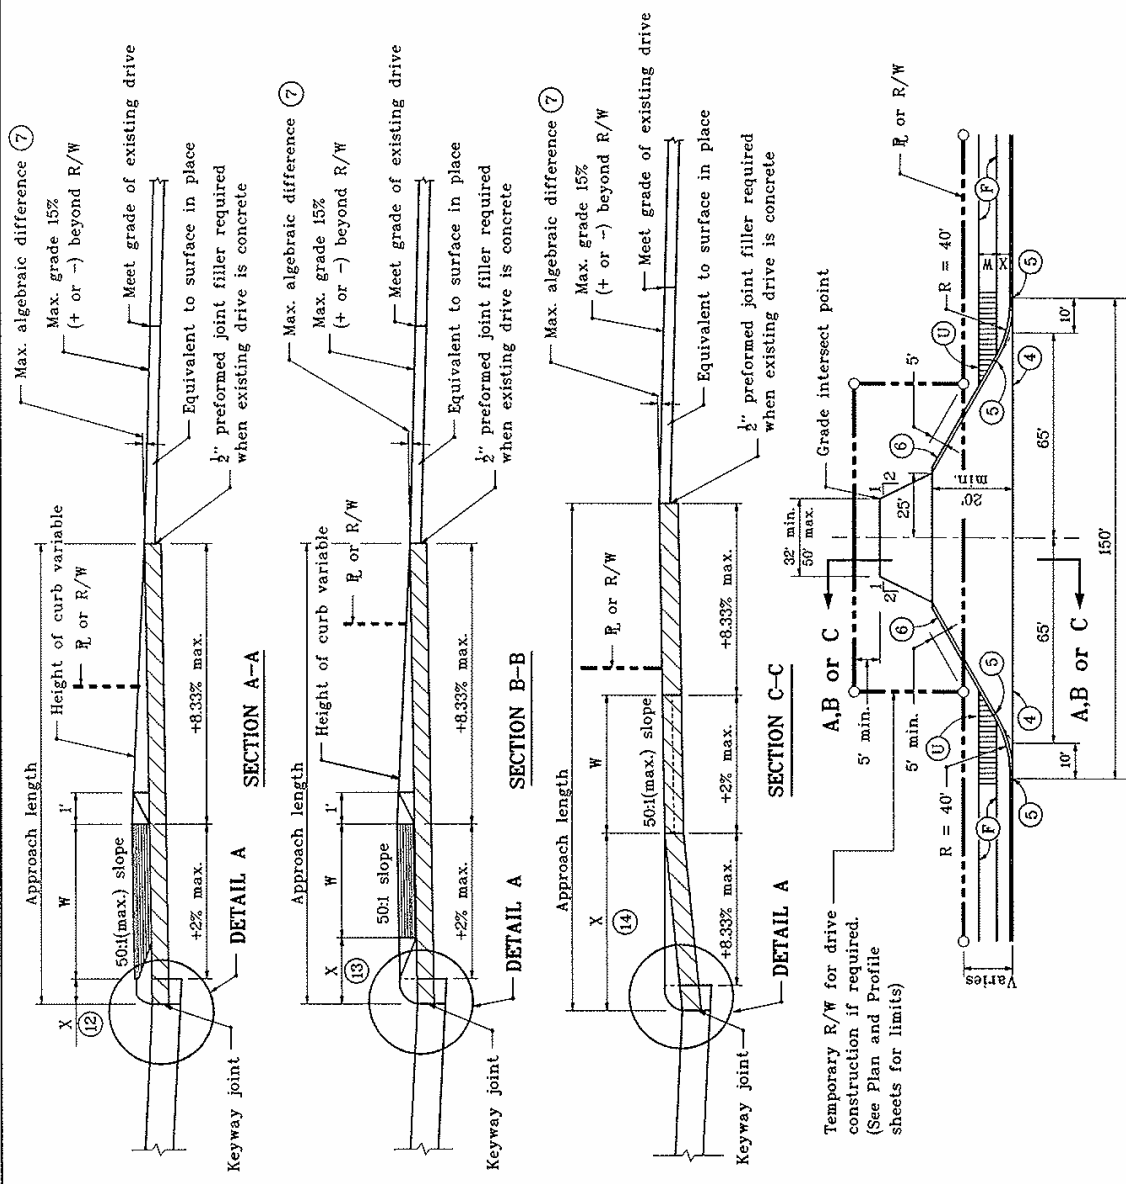

NOTES :


1. The Class VII drive shall be specified at truck stops and entrances to heavy industrial property.
2. All Class VII drives shall be concrete to at least the Right-of-Way line with minimum length 20'.
3. See Standard Drawing E 610-DRIV-16 for keyway joint shown in Detail A and for joint placement and corner reinforcement.
4. See Standard Drawing E 610-DRIV-14 for General Notes and Legend.

13



INDIANA DEPARTMENT OF TRANSPORTATION	
CLASS VII DRIVE	
PLAN AND PROFILE GRADE	
JANUARY 2000	
STANDARD DRAWING NO. E 610-DRIV-15	
	Anthony L. Derewich DESIGN STANDARDS ENGINEER DATE: 1-03-00
	Feroz Zandi CHIEF HIGHWAY ENGINEER DATE: 1-03-00

CLASS VII DRIVE (COMMERCIAL)


- NOTES :**
1. See Standard Drawing E 610-DRIV-15 for plan and profiles of Class VII drive.
 2. See Standard Drawing E 610-DRIV-13 for General Notes and Legend.
 3. DETAIL A - shows keyway construction joint in detail. For location see Drawing E 610-DRIV-15.

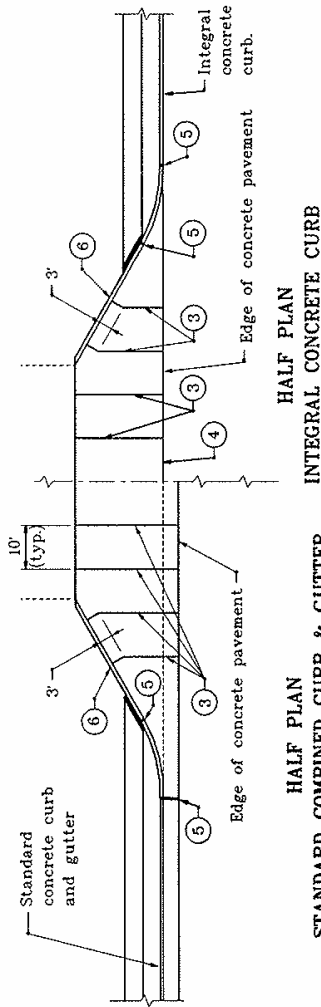


JOINT PLACEMENT DETAIL

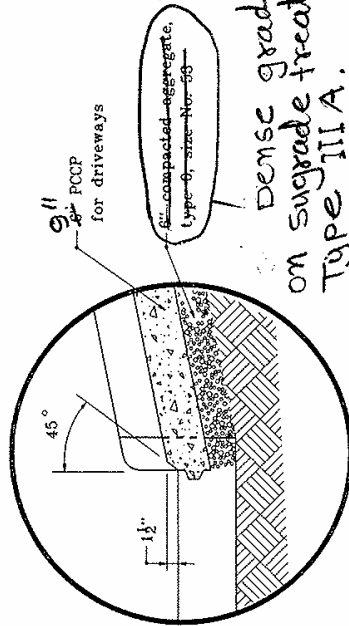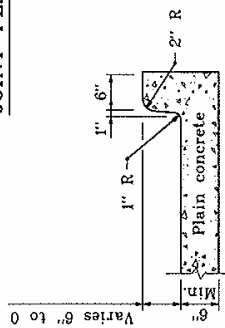


Dense graded subbase on subgrade treatment Type III A.

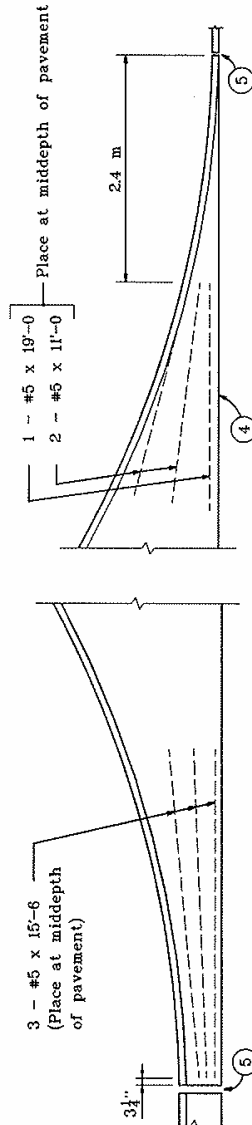

INDIANA DEPARTMENT OF TRANSPORTATION	
CLASS VII DRIVE	
JOINT PLACEMENT AND CORNERS	
JANUARY 2000	
STANDARD DRAWING NO. E 610-DRIV-16	
L. URBANOVICH No. 18035 STATE OF INDIANA PROFESSIONAL ENGINEER	/s/ Anthony L. Urbanovich DESIGN STANDARDS ENGINEER DATE 1-03-00
/s/ Preet Zandi CHIEF HIGHWAY ENGINEER	DATE 1-03-00

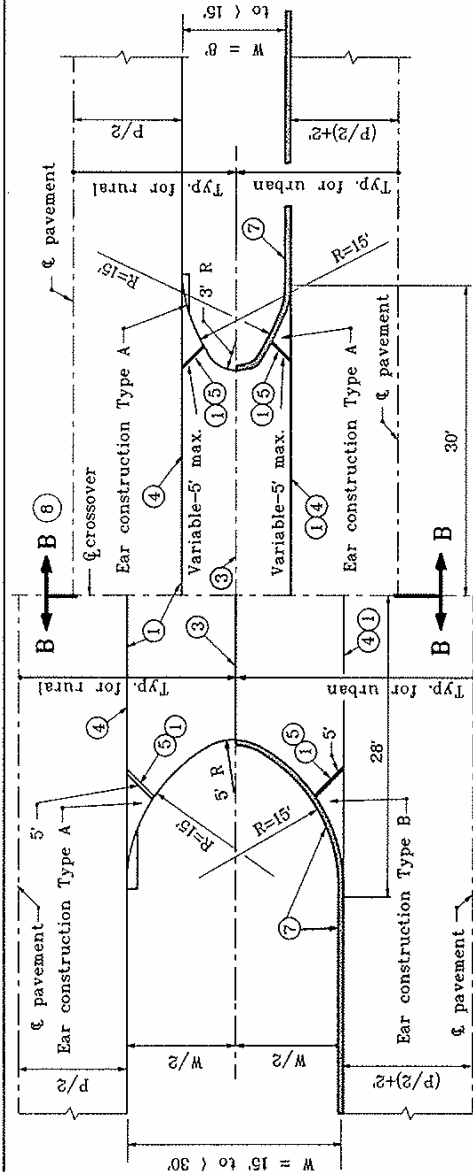

PRIVATE DRIVE CROSSOVER PLAN FOR $W = 8'$ to less than $30'$

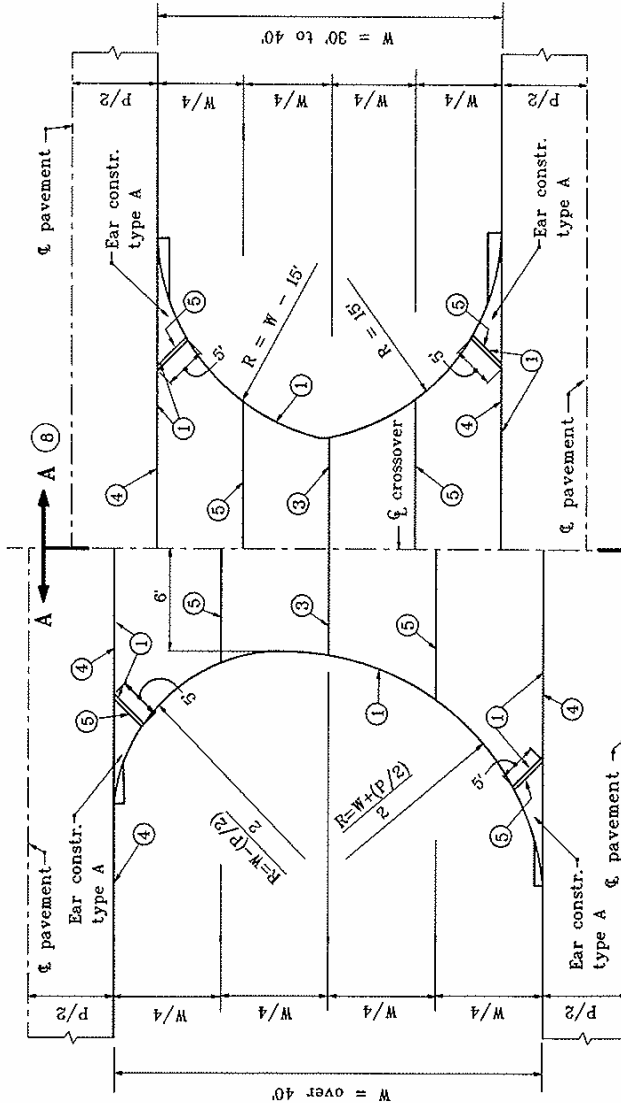

PRIVATE DRIVE CROSSOVER PLAN FOR $W = 30'$ to over $40'$

NOTES :

1) Thickened edge

2) See Standard Drawings:
E 605-ERCN-01 for TYPE "A" ear construction
E 605-ERCN-02 for TYPE "B" ear construction
E 610-DRIV-17 for sections A-A and B-B

3) Contraction joint type D-1, see Standard Drawing E 503-CCPJ-01 for details.

4) Keyway construction joint, see Standard Drawing E 610-DRIV-16 for details.

5) 1" preformed joint filler

6) Private drive crossover shall be constructed of a flexible section unless otherwise directed by the engineer.

7) Integral concrete curb, see Standard Drawing E 605-CCIN-01 for details.

8) For cross sections A-A and B-B see Standard Drawing E 610-DRIV-18.


INDIANA DEPARTMENT OF TRANSPORTATION


PRIVATE DRIVE CROSSOVERS
PLANS

JANUARY 2000

STANDARD DRAWING NO. E 610-DRIV-17

L. UREMOWICZ No. 18095 STATE OF INDIANA PROFESSIONAL ENGINEER	/s/ Anthony L. Uremowicz DESIGN STANDARDS ENGINEER DATE
	/s/ Ferooz Zandi CHIEF HIGHWAY ENGINEER DATE

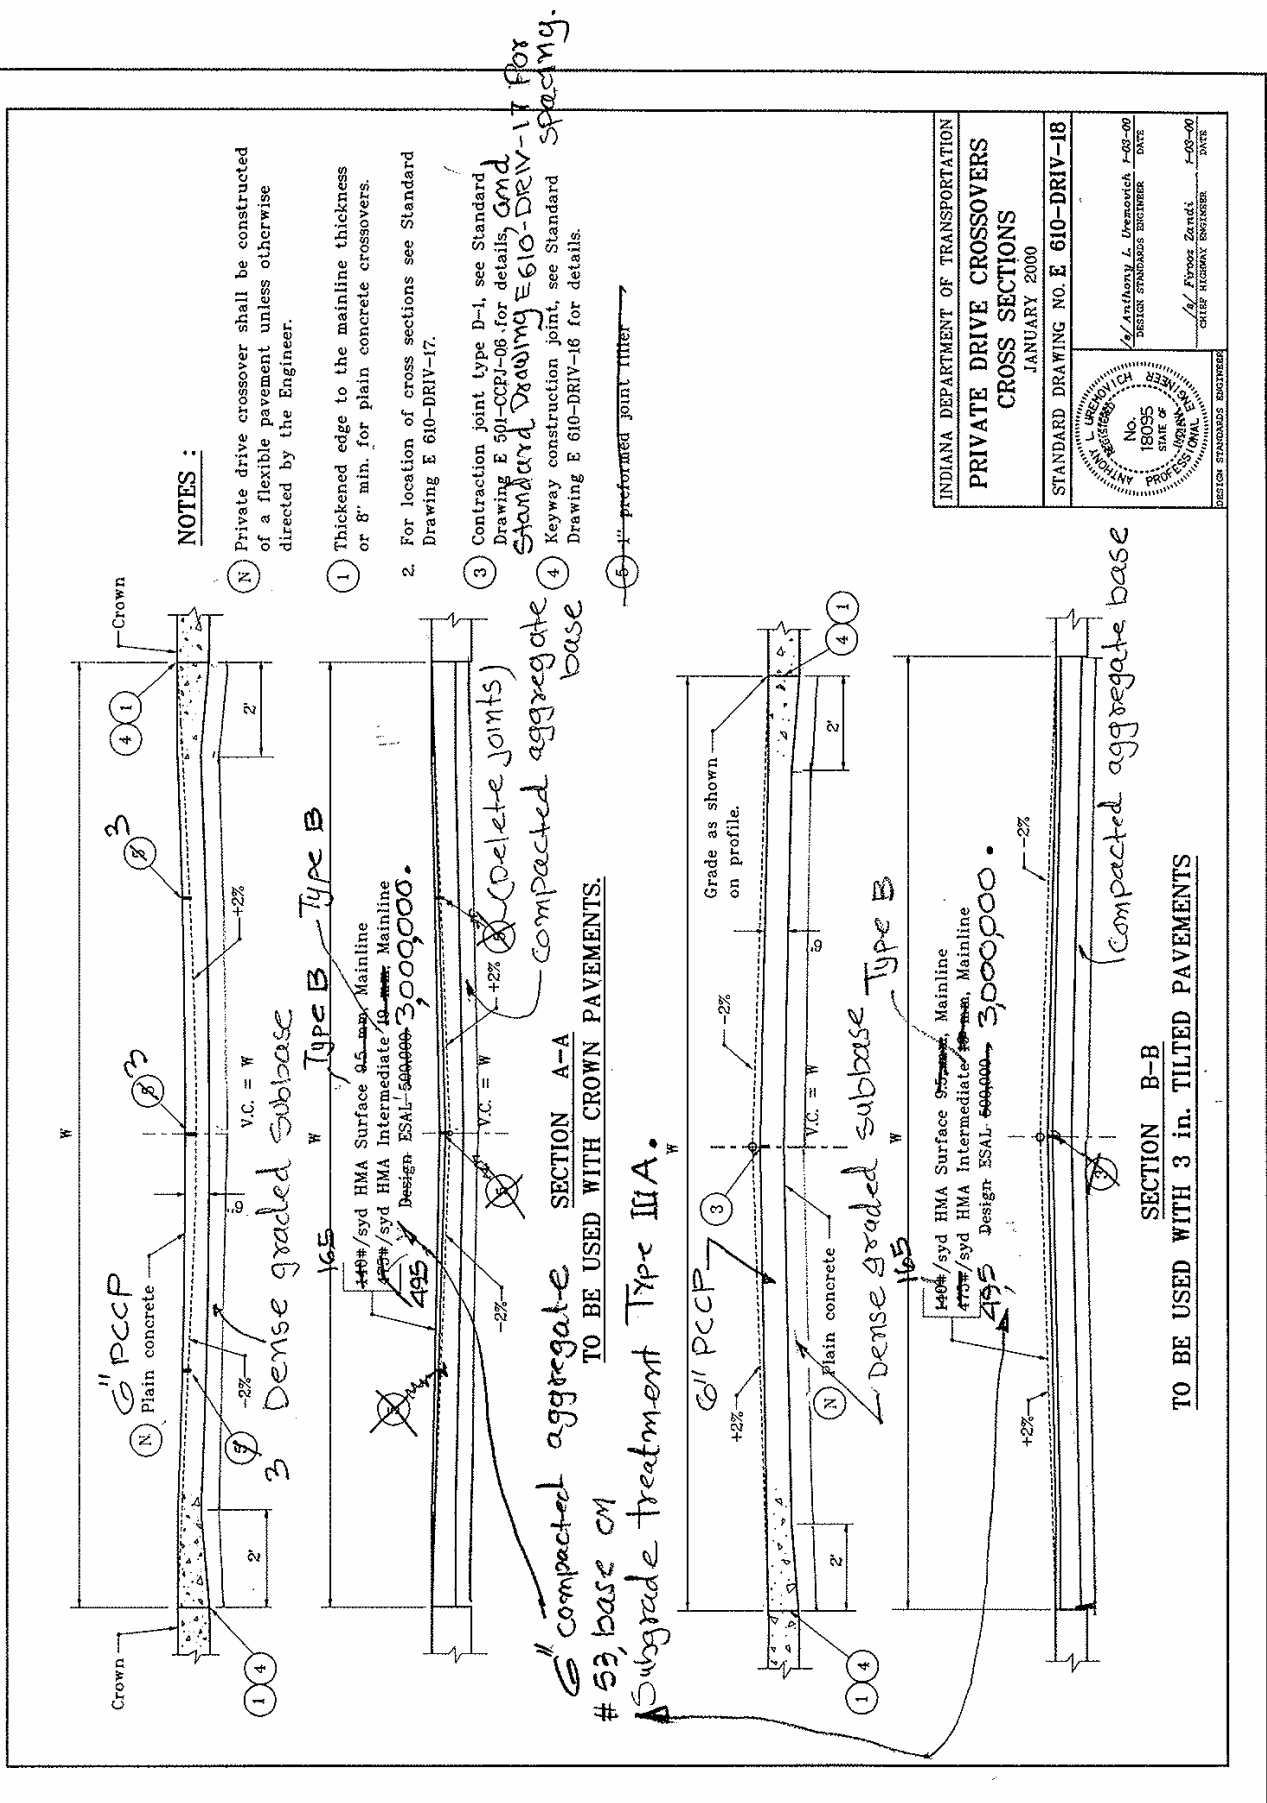

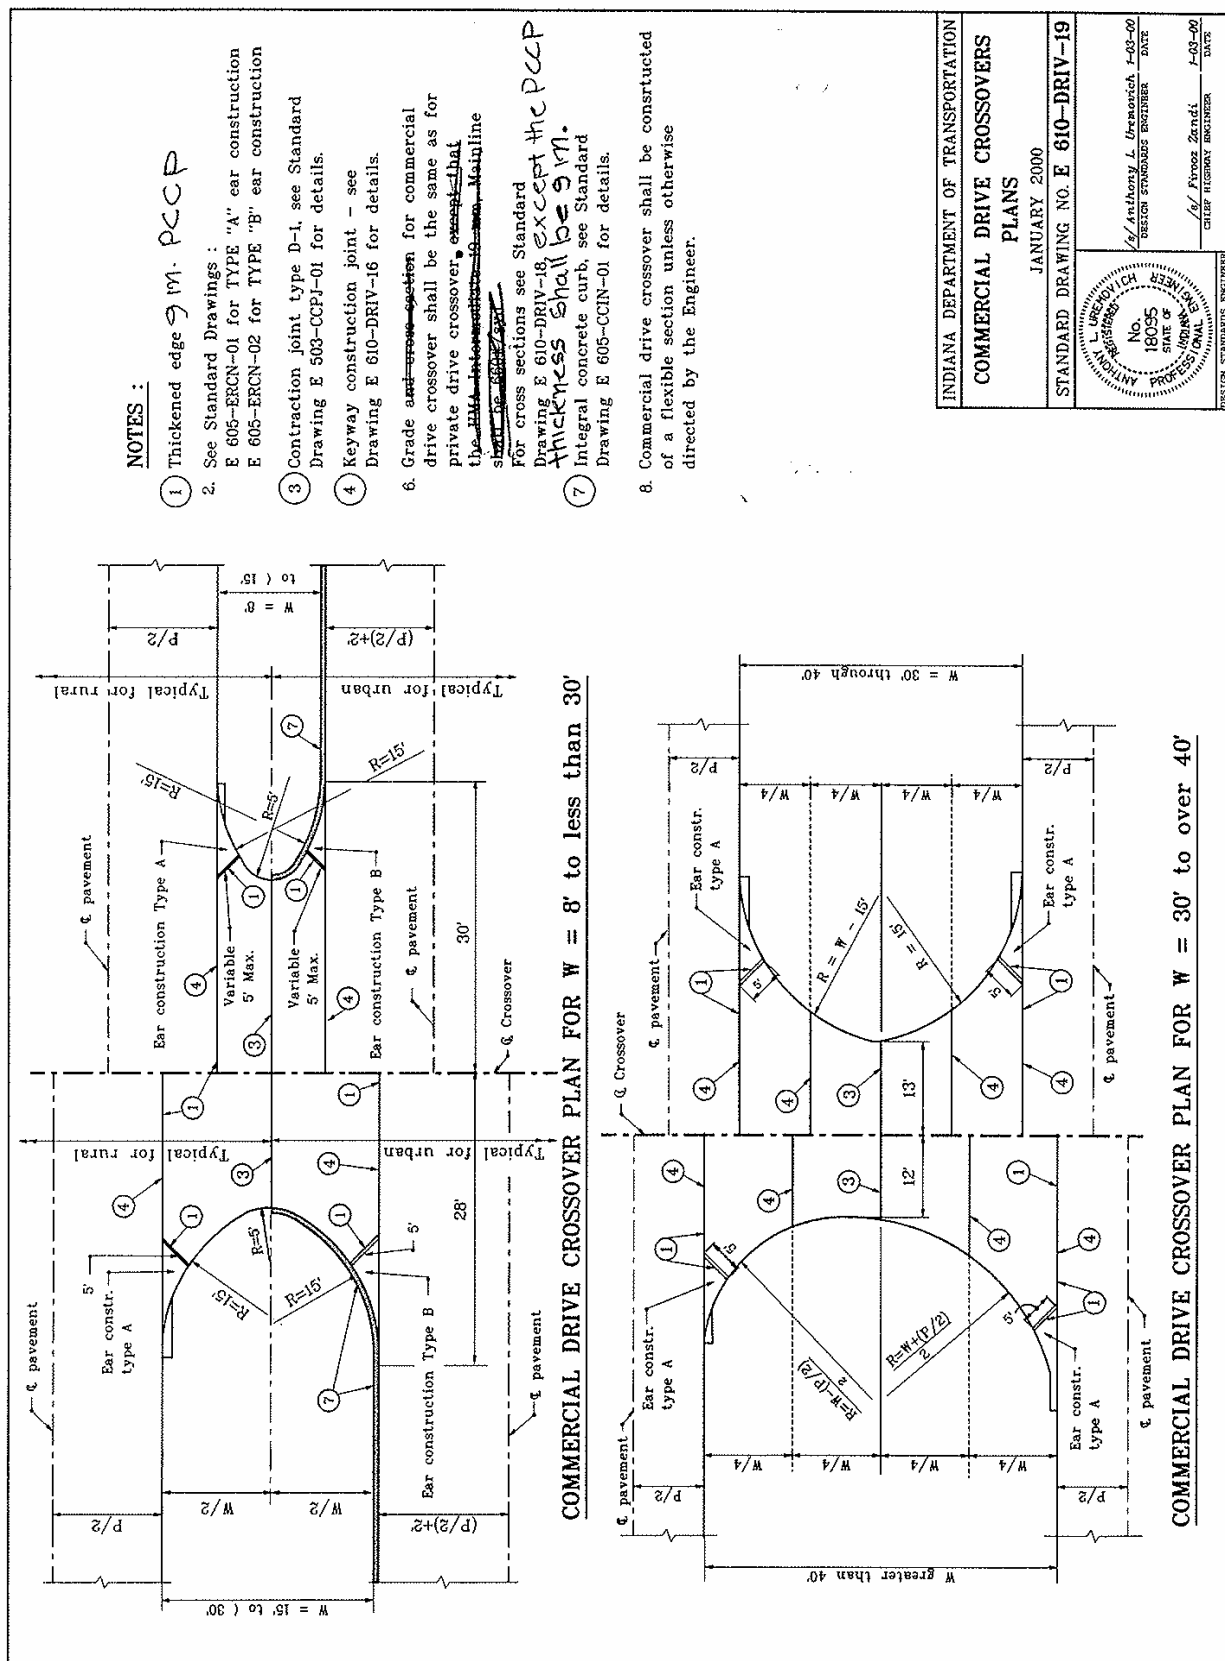

INDIANA DEPARTMENT OF TRANSPORTATION	
COMMERCIAL DRIVE CROSSOVERS PLANS	
JANUARY 2000	
STANDARD DRAWING NO. E 610-DRIV-19	
	/s/ Anthony L. Drenovich 1-03-00 DESIGN STANDARDS ENGINEER DATE
	/s/ Pirooz Zandi 1-03-00 CHIEF DESIGN ENGINEER DATE
DESIGN STANDARDS DIVISION	

August 28, 2006

**DESIGN MEMORANDUM No. 06-XX
TECHNICAL ADVISORY**

TO: All Design, Operations, and District Personnel, and Consultants

FROM: Richard L. VanCleave
Design Policy Engineer
Office of Roadway Engineering Services

SUBJECT: PCCP Thickness for Drive Approaches
EFFECTIVE: XXXXXX, 2006 Letting

The PCCP thickness for commercial and industrial drives is being changed from 6" PCCP on 6" compacted aggregate base to 9" PCCP on dense graded subbase on subgrade treatment Type IIIA. These drives are designed for 400 trucks per day which also accommodate a WB-65, the Indiana Design Vehicle. The corresponding changes to HMA pavement thicknesses for these drives also have been made. There is no change in the PCCP thickness for residential drives which will remain 6" PCCP thickness as shown currently on the Standard Drawings. The following Standard Drawings, both Metric and English, have been revised to incorporate the PCCP thickness changes for the construction of the drives:

E 610-DRIV-01	E 610-DRIV-13
E 610-DRIV-02	E 610-DRIV-15
E 610-DRIV-03	E 610-DRIV-16
E 610-DRIV-04	E 610-DRIV-17
E 610-DRIV-06	E 610-DRIV-18
E 610-DRIV-08	E 610-DRIV-19
E 610-DRIV-12	

These revisions to the Standard Drawings do not require a Design Manual change. Designers are instructed to call for the revised Standard Drawings in the contract documents.

REVISION TO 2006 STANDARD SPECIFICATIONS

SECTION 715, BEGIN LINE 17, DELETE AS FOLLOWS:

Concrete used for anchors, collars, grated box end sections, encasements, and sealing existing pipes shall be class A. Corrugated polyethylene pipe, type S has a smooth interior liner with a corrugated outer wall. Type SP pipe is a type S pipe with perforations. ~~Polymer precoated galvanized corrugated steel pipe type IA and pipe arch type IIA have an outer shell of corrugated sheet with helical corrugations and an inner liner of smooth sheet attached to the shell with a helical lock seam.~~

Other sections containing specific cross references:	General Instructions to Field Employees Update Required? Y___ N___ By - Addition or Revision Frequency Manual Update Required? Y___ N___ By - Addition or Revision
717.02 Pg 700-121	
Recurring Special Provisions potentially affected:	Standard Sheets potentially affected:
None	None
Motion: M Second: M Ayes: Nays:	Action: Passed as submitted; revised Effective: _____ Letting _____ 2008 Standards Specifications Book _____ 2008 Standards Edition Withdrawn _____ Received FHWA Approval? _____

REVISION TO 2006 STANDARD SPECIFICATIONS

SECTION 715, AFTER LINE 149, INSERT AS FOLLOWS:

(k) Pipe End Sections

Pipe end sections shall be in accordance with 908.06.

Other sections containing
specific cross references:

None

General Instructions to Field Employees

Update Required? Y___ N___

By - Addition or Revision

Frequency Manual

Update Required? Y___ N___

By - Addition or Revision

Recurring Special Provisions
potentially affected:

None

Standard Sheets potentially affected:

None

Motion: M

Second: M

Ayes:

Nays:

Action: Passed as submitted; revised

Effective: _____ Letting

_____ 2008 Standards Specifications Book

_____ 2008 Standards Edition

Withdrawn _____

Received FHWA Approval? _____

REVISION TO 2006 STANDARD SPECIFICATIONS

SECTION 715, BEGIN LINE 239, INSERT AS FOLLOWS:

715.06 Joining Pipe

Band couplers for AASHTO M 36 (M 36M) type I and type II corrugated steel pipe and pipe-arches shall have corrugations that mesh with the corrugations of the pipe sections being joined or the annular rerolled ends of those pipe sections. Band couplers with projections (dimples) may be used with pipe having either annular or helical corrugations only when corrugated band couplers will not provide a matching connection to both pipes. Band couplers for AASHTO M 36 (M 36M) type IA and IIA corrugated steel pipe and pipe-arches shall have corrugations that mesh with the corrugations of the pipe or shall be gasketed flat bands.

Other sections containing
specific cross references:

908.02 Pg 900-49

Recurring Special Provisions
potentially affected:

None

Motion: M
Second: M
Ayes:
Nays:

General Instructions to Field Employees

Update Required? Y___ N___

By - Addition or Revision

Frequency Manual

Update Required? Y___ N___

By - Addition or Revision

Standard Sheets potentially affected:

None

Action: Passed as submitted; revised
Effective: _____ Letting
_____ 2008 Standards Specifications Book
_____ 2008 Standards Edition

Withdrawn _____

Received FHWA Approval? _____

REVISION TO 2006 STANDARD SPECIFICATIONS

SECTION 724, BEGIN LINE 33, DELETE AND INSERT AS FOLLOWS:

(b) Expansion Joint M

This joint shall consist of prefabricated, multiple elastomeric seals, separator beams, and support bars. The structural design of expansion joint M shall be in accordance with the current AASHTO Standard Specifications for Highway Bridges and shall be for the same design loading as the bridge structure at which it is installed, but in no case less than HS 20 – 44 truck loading and impact. The joint shall be designed to accommodate the movement shown on the plans. ~~The sliding cover plate required over that portion of expansion joint M located in a sidewalk or concrete rail shall be the same material as the extrusion and shall be galvanized in accordance with ASTM A 123.~~

~~The manufacturer of the joint assembly shall prepare shop drawings showing details of the assembly. Three sets of the shop drawings, manufacturer's specifications and joint setting data shall be submitted for approval. This information shall be approved prior to manufacture of the joint.~~

The joint shall be constructed in accordance with the details shown on the shop drawings as prepared by the manufacturer of the expansion joint assembly.

The modular expansion joint assembly shall be preset by the manufacturer in accordance with the approved shop drawings, joint setting data and specifications. The assembly shall be properly secured for shipping and contain provision for final field adjustment at the time of installation. Final adjustment of the assembly shall be made at the direction of the Engineer. All movements due to factors such as shrinkage, creep and mid-slab deflection shall be properly accounted for prior to this final adjustment.

The joint, including anchor assembly, shall be shop fabricated, delivered and installed as a continuous unit for lengths up to 44 ft (13 m). Joints longer than 44 ft (13 m) shall be furnished in continuous units or in appropriate shorter sections as shown on the shop drawings and approved by the Engineer. Joints used in stage construction shall be furnished in sections appropriate to accommodate the work. All joints furnished in sections shall be spliced with welds, with ends prepared for welding in the shop. All welds, both shop and field, shall be in accordance with 711.32.

All welds in contact with the elastomeric seals shall be ground smooth. Metal surfaces in direct contact with the elastomeric seal shall be clean and properly treated in accordance with the manufacturer's recommendations to provide a high strength bond between elastomeric seal and mating metal surfaces. The elastomeric seals shall be clean and free of foreign materials. All exposed structural steel surfaces, except stainless steel or teflon coated, shall be painted in accordance with 619.

The method of installation of the joint, including all items incidental to the installation, shall be in accordance with the recommendations of the manufacturer. In all cases, excess sealant shall be removed before it has set. The Contractor shall submit for approval the manufacturer's recommendations for the installation of the joint. This information shall be approved before installation begins.

REVISION TO 2006 STANDARD SPECIFICATIONS

SECTION 724 CONTINUED.

The profile of the joint in the roadway area shall conform to the roadway cross section. Where changes in direction are required, such as at curbs or concrete rails, the sections shall be cut to the bevel required to produce the same cross section on each piece being joined. Slider plates shall be provided at curbs, walkways and concrete rails as part of the completed joint assembly.

SECTION 724, BEGIN LINE 45, DELETE AND INSERT AS FOLLOWS:

724.03 General Requirements

The manufacturer shall prepare ~~and submit four sets of~~ detailed shop drawings showing details of the assembly, for approval, prior to the manufacture of joint assemblies SS and M. The shop drawings shall be a minimum of 22 in. by 34in. (560 mm by 860 mm) in overall size. ~~Expansion joints SS and M shall not be fabricated until the shop drawings are approved.~~ Four sets of shop drawings, manufacturer's specifications, and joint setting data shall be submitted. Joint installation and the replacement of existing joints shall be in accordance with the manufacturer's recommendations, the plans, and the approved shop drawings. If there is a dispute between the plans and the approved shop drawings, the approved shop drawings shall govern. The manufacturer shall furnish a copy of the installation instructions prior to the placement of these joints.

Other sections containing
specific cross references:

None

Recurring Special Provisions
potentially affected:

724-B-046

Motion: Mr.
Second: Mr.
Ayes:
Nays:

General Instructions to Field Employees

Update Required? Y___ N___

By - Addition or Revision

Frequency Manual

Update Required? Y___ N___

By - Addition or Revision

Standard Sheets potentially affected:

None

Action: Passed as submitted; revised
Effective - _____ Letting
_____ Supplementals

Withdrawn

Received FHWA Approval? _____

REVISION TO 2006 STANDARD SPECIFICATIONS

SECTION 801, BEGIN LINE 693, INSERT AS FOLLOWS:

Wherever a permanent speed limit sign exists within the limits controlled by the worksite speed limit sign assemblies, additional worksite speed limit sign assemblies shall be placed next to the permanent signs *if the permanent signs are not covered.*

Other sections containing
specific cross references:

None

General Instructions to Field Employees

Update Required? Y___ N___

By - Addition or Revision

Frequency Manual

Update Required? Y___ N___

By - Addition or Revision

Recurring Special Provisions
potentially affected:

801-T-158

Standard Sheets potentially affected:

None

Motion: M

Second: M

Ayes:

Nays:

Action: Passed as submitted; revised

Effective: _____ Letting

_____ 2008 Standards Specifications Book

_____ 2008 Standards Edition

Withdrawn _____

Received FHWA Approval? _____

REVISION TO 2006 STANDARD SPECIFICATIONS

SECTION 905, BEGIN LINE 36, INSERT AS FOLLOWS:

905.05 Detectable Warning Elements

Detectable warning bricks used in sidewalk curb ramps shall be in accordance with ASTM C 902, Class SX, type II. The color shall approximate 30109 or 30166 in accordance with Federal Standard No. 595a. The color shall be consistent throughout the brick. The truncated domes shall be as shown on the plans. The minimum dimensions of the brick shall be 2 1/4 in. (60 mm) thick by 3 5/8 in. (90 mm) wide by 7 5/8 in. (195 mm) long. The minimum thickness shall not be measured within the area of the domes. *Detectable warning elements shall be selected from the Department's list of approved Detectable Warning Elements.*

Other sections containing
specific cross references:

604.02

General Instructions to Field Employees

Update Required? Y___ N___

By - Addition or Revision

Frequency Manual

Update Required? Y___ N___

By - Addition or Revision

Recurring Special Provisions
potentially affected:

None

Standard Sheets potentially affected:

None

Motion: M
Second: M
Ayes:
Nays:

Action: Passed as submitted; revised
Effective: _____ Letting
_____ 2008 Standards Specifications Book
_____ 2008 Standards Edition

Withdrawn _____

Received FHWA Approval? _____

REVISION TO 2006 STANDARD SPECIFICATIONS

SECTION 908, BEGIN LINE 5, DELETE AND INSERT AS FOLLOWS:

908.02 Corrugated Steel Pipe and Pipe-Arches

Corrugated steel pipe and pipe-arches shall be type I, IA, II, or IIA in accordance with AASHTO M 36 (M 36M).

~~This~~ *Corrugated steel pipe, or pipe-arches, and the coupling bands shall be zinc coated steel or aluminum coated steel in accordance with AASHTO M 36 (M 36M), except as noted herein. They may be fabricated with circumferential corrugations and riveted lap joint construction or with helical corrugations with continuous lock or welded seam extending from end to end of each length of pipe. Reforming the ends of helical corrugated pipe to form circumferential corrugations will be permitted to allow use of circumferential corrugated coupling bands. The reforming shall be limited to the length required to accommodate the coupling bands and in such a manner that there is not appreciable slippage of the seam nor a plane of weakness created.*

~~The pipe shall be type I, IA, II, or IIA.~~

~~Band couplers for type I and type II pipe shall have corrugations that mesh with the corrugations of the pipes sections being joined or the annular rerolled ends of those pipe sections. Band couplers for type IA and IIA pipe shall have corrugations that mesh with the corrugations of the pipe or shall be gasketed flat bands.~~

Polymer precoated galvanized corrugated steel pipe type IA and pipe-arch type IIA have an outer shell of corrugated sheet with helical corrugations and an inner liner of smooth sheet attached to the shell with a helical lock seam.

Other sections containing specific cross references:	General Instructions to Field Employees Update Required? Y___ N___ By - Addition or Revision Frequency Manual Update Required? Y___ N___ By - Addition or Revision
715.02(a) Pg 700-105	
715.02(e) Pg 700-107	
908.04 Pg 900-50	
908.06 Pg 900-50	
908.07 Pg 900-51	
908.08 Pg 900-52	
908.09(a) Pg 900-52	
908.09(b) Pg 900-52	
Recurring Special Provisions potentially affected:	Standard Sheets potentially affected:
None	None
Motion: M	Action: Passed as submitted; revised
Second: M	Effective: _____ Letting
Ayes:	_____ 2008 Standards Specifications Book
Nays:	_____ 2008 Standards Edition
	Withdrawn _____
	Received FHWA Approval? _____

REVISION TO 2006 STANDARD SPECIFICATIONS

SECTION 918, BEGIN LINE 22h, DELETE AS FOLLOWS:

GEOTEXTILE MATERIAL PROPERTIES

TEST	METHOD	REQUIREMENTS*
Tensile Strength	Grab Tensile Strength, ASTM D 4632	200 lb (890 N)
Elongation	Grab Tensile Strength, ASTM D 4632	15%
Seam Strength	Grab Tensile Strength, ASTM D 4632	180 lb (800 N)
Bursting Strength	Mullen Burst, ASTM D 3786	320 psi (2.21 MPa)
Puncture Strength	ASTM D 4833	80 lb (356 N)
Trapezoid Tear	ASTM C 4533	50 lb (225 N)
Ultraviolet Degradation at 150 h	ASTM D 4355	70% strength retained
Apparent Opening Size (AOS)	ASTM D 4751	AOS shall be No. 50 (300 µm) standard sieve or filter
Permeability**	ASTM D 4491 (Permittivity)	0.01 cm/sec or >

* Use value in weaker principal direction. All numerical values represent minimum average roll value and test results from any sampled roll in a lot shall meet or exceed the minimum values in the table. Lots shall be sampled according to ASTM D 4354.

** The nominal coefficient of permeability shall be determined by multiplying permittivity value by nominal thickness. The nominal thickness is measured under a normal load of 280 psi (1.93 MPa).

Other sections containing
specific cross references:

205.02 Pg 200-49
211.02 Pg 200-69
616.02 Pg 600-44
714.02 Pg 700-102

General Instructions to Field Employees

Update Required? Y___ N___

By - Addition or Revision

Frequency Manual

Update Required? Y___ N___

By - Addition or Revision

Recurring Special Provisions
potentially affected:

None

Standard Sheets potentially affected:

None

Motion: M
Second: M
Ayes:
Nays:

Action: Passed as submitted; revised
Effective: _____ Letting
_____ 2008 Standards Specifications Book
_____ 2008 Standards Edition

Withdrawn _____

Received FHWA Approval? _____

From: Smith, Dan
Sent: Monday, August 28, 2006 3:52 PM
To: Chumbley, Sharman
Subject: FW: Specification For DWE
For September agenda.

Thanks

Dannie L. Smith
Indiana Department of Transportation
Specifications Engineer
Rm N855
Phone (317) 232-5353
Fax (317) 232-0676

From: Walker, Ronald
Sent: Monday, August 28, 2006 3:36 PM
To: Smith, Dan
Subject: RE: ~~Specification For DWE~~

Dan, ~~We are not ready for this specification to be placed on the Standards Committee agenda. We are trying to tie up some loose ends on existing contracts that the current spec is very vague on. There is a Committee studying the use of other types of DWE materials and I would prefer to wait until their study is complete before revising the Standard Specifications.~~

Also, I have attached one item just recently presented to me by Geotechnical concerning Geotextiles. Please add this item to the agenda. You may want to check the line reference to verify if that is correct line.

Thanks, Ron

-----Original Message-----

From: ~~Smith, Dan~~
Sent: ~~Wednesday, August 23, 2006 1:36 PM~~
To: ~~Walker, Ronald~~
Subject: ~~FW: Specification For DWE~~

-
~~Are you ready for this to be placed on a Standards Committee agenda?~~

Thanks

Dannie L. Smith
Indiana Department of Transportation
Specifications Engineer
Rm N855
Phone (317) 232-5353
Fax (317) 232-0676

Item No. 15-14
Mr. Wright
Date: 9/21/06

DESIGN MANUAL CHANGE

Design Manual Change to Section 14-1.02(02) and Section 17-3.02(2)

Interim revisions relating to Field Check Report and Subgrade Treatment Type Determination respectively. This interim change will remain in effect until superseded by an official Design Manual revision or another Design Memorandum/Policy Change document.

Other sections containing
specific cross references:

None

General Instructions to Field Employees

Update Required? Y___ N___

By - Addition or Revision

Frequency Manual

Update Required? Y___ N___

By - Addition or Revision

Recurring Special Provisions
potentially affected:

None

Standard Sheets potentially affected:

None

Motion: M
Second: M
Ayes:
Nays:

Action: Passed as submitted; revised
Effective: _____ Letting
_____ 2008 Standards Specifications Book
_____ 2008 Standards Edition

Withdrawn _____

Received FHWA Approval? _____



July 23, 2006

**DESIGN MEMORANDUM No. 06-XX
DESIGN MANUAL CHANGE**

TO: All Design, Operations, and District Personnel, and Consultants

FROM: /s/ *Richard L. VanCleave*
Richard L. VanCleave
Design Policy Engineer
Office of Roadway Engineering Services

SUBJECT: Design Manual Sections 14-1.02(02) and 17-3.02(02)

EFFECTIVE: XXXXXXXX, 2006

REVISES: Design Manual Sections 14-1.02(02) and 17-3.02(02)

The Design Manual Sections 14-1.02(02) and 17-3.02(02) have been revised.

Attached are interim revisions of Sections 14-1.02(02) and 17-3.02(02) of the Design Manual relating to Field Check Report and Subgrade Treatment Type Determination respectively. This interim Design Manual change will remain in effect until superseded by an official Design Manual revision or another Design Memorandum/Policy Change document. Designers are instructed to follow the attached interim procedure.

14-1.02(02) Field Check – Consultant Project

Revise the paragraph under 4, Field Check Report as follows:

4. Field Check Report. After the field check has been completed, the consultant will be responsible for preparing the report of meeting and listing the comments from all individuals involved in the field check. Copies of this report will be distributed to all those involved in the field check and to those individuals listed in the distribution in Figure 14-1B. *The following should be discusses in the field check report:*

The Geotechnical Section should be informed of possible shallow utilities, temporary pavement, and need for a temporary runaround or night construction so that they can make suitable recommendations for subgrade type. Such considerations should be documented in the field check minutes

17-3.02(02) Subgrade Treatment Type Determination

Delete the first paragraph under 2 and revise the second paragraph as follows:

2. ~~Project With Subgrade Treatment Type Yet to be Determined. The preliminary field check plans should include projected AADT figures and subgrade treatment areas tabulated for each survey line as shown in Figure 17-3B. During the field check, the Geotechnical Section should be informed of possible shallow utilities, temporary pavement, and need for a temporary runaround or night construction so that they can make suitable recommendations for subgrade type. Such considerations should be documented in the field check minutes.~~

The type or types of subgrade treatments described in Section 17-3.02(01) to be used will be specified in the Geotechnical Report. If the Geotechnical Report does not specify the subgrade treatment type, the designer should send a memorandum requesting the subgrade treatment to the *Planning and Production Division's Geotechnical Section with a subgrade tabulation sheet as shown in figure 17-3B.*

The field check may have already been conducted, but the Geotechnical Report may not yet have been received by the designer. For this situation, the designer should submit to the Geotechnical Section the tabulation and information regarding shallow utilities, temporary pavement, and need for a temporary runaround or night construction so that they can make suitable recommendations for subgrade type.